


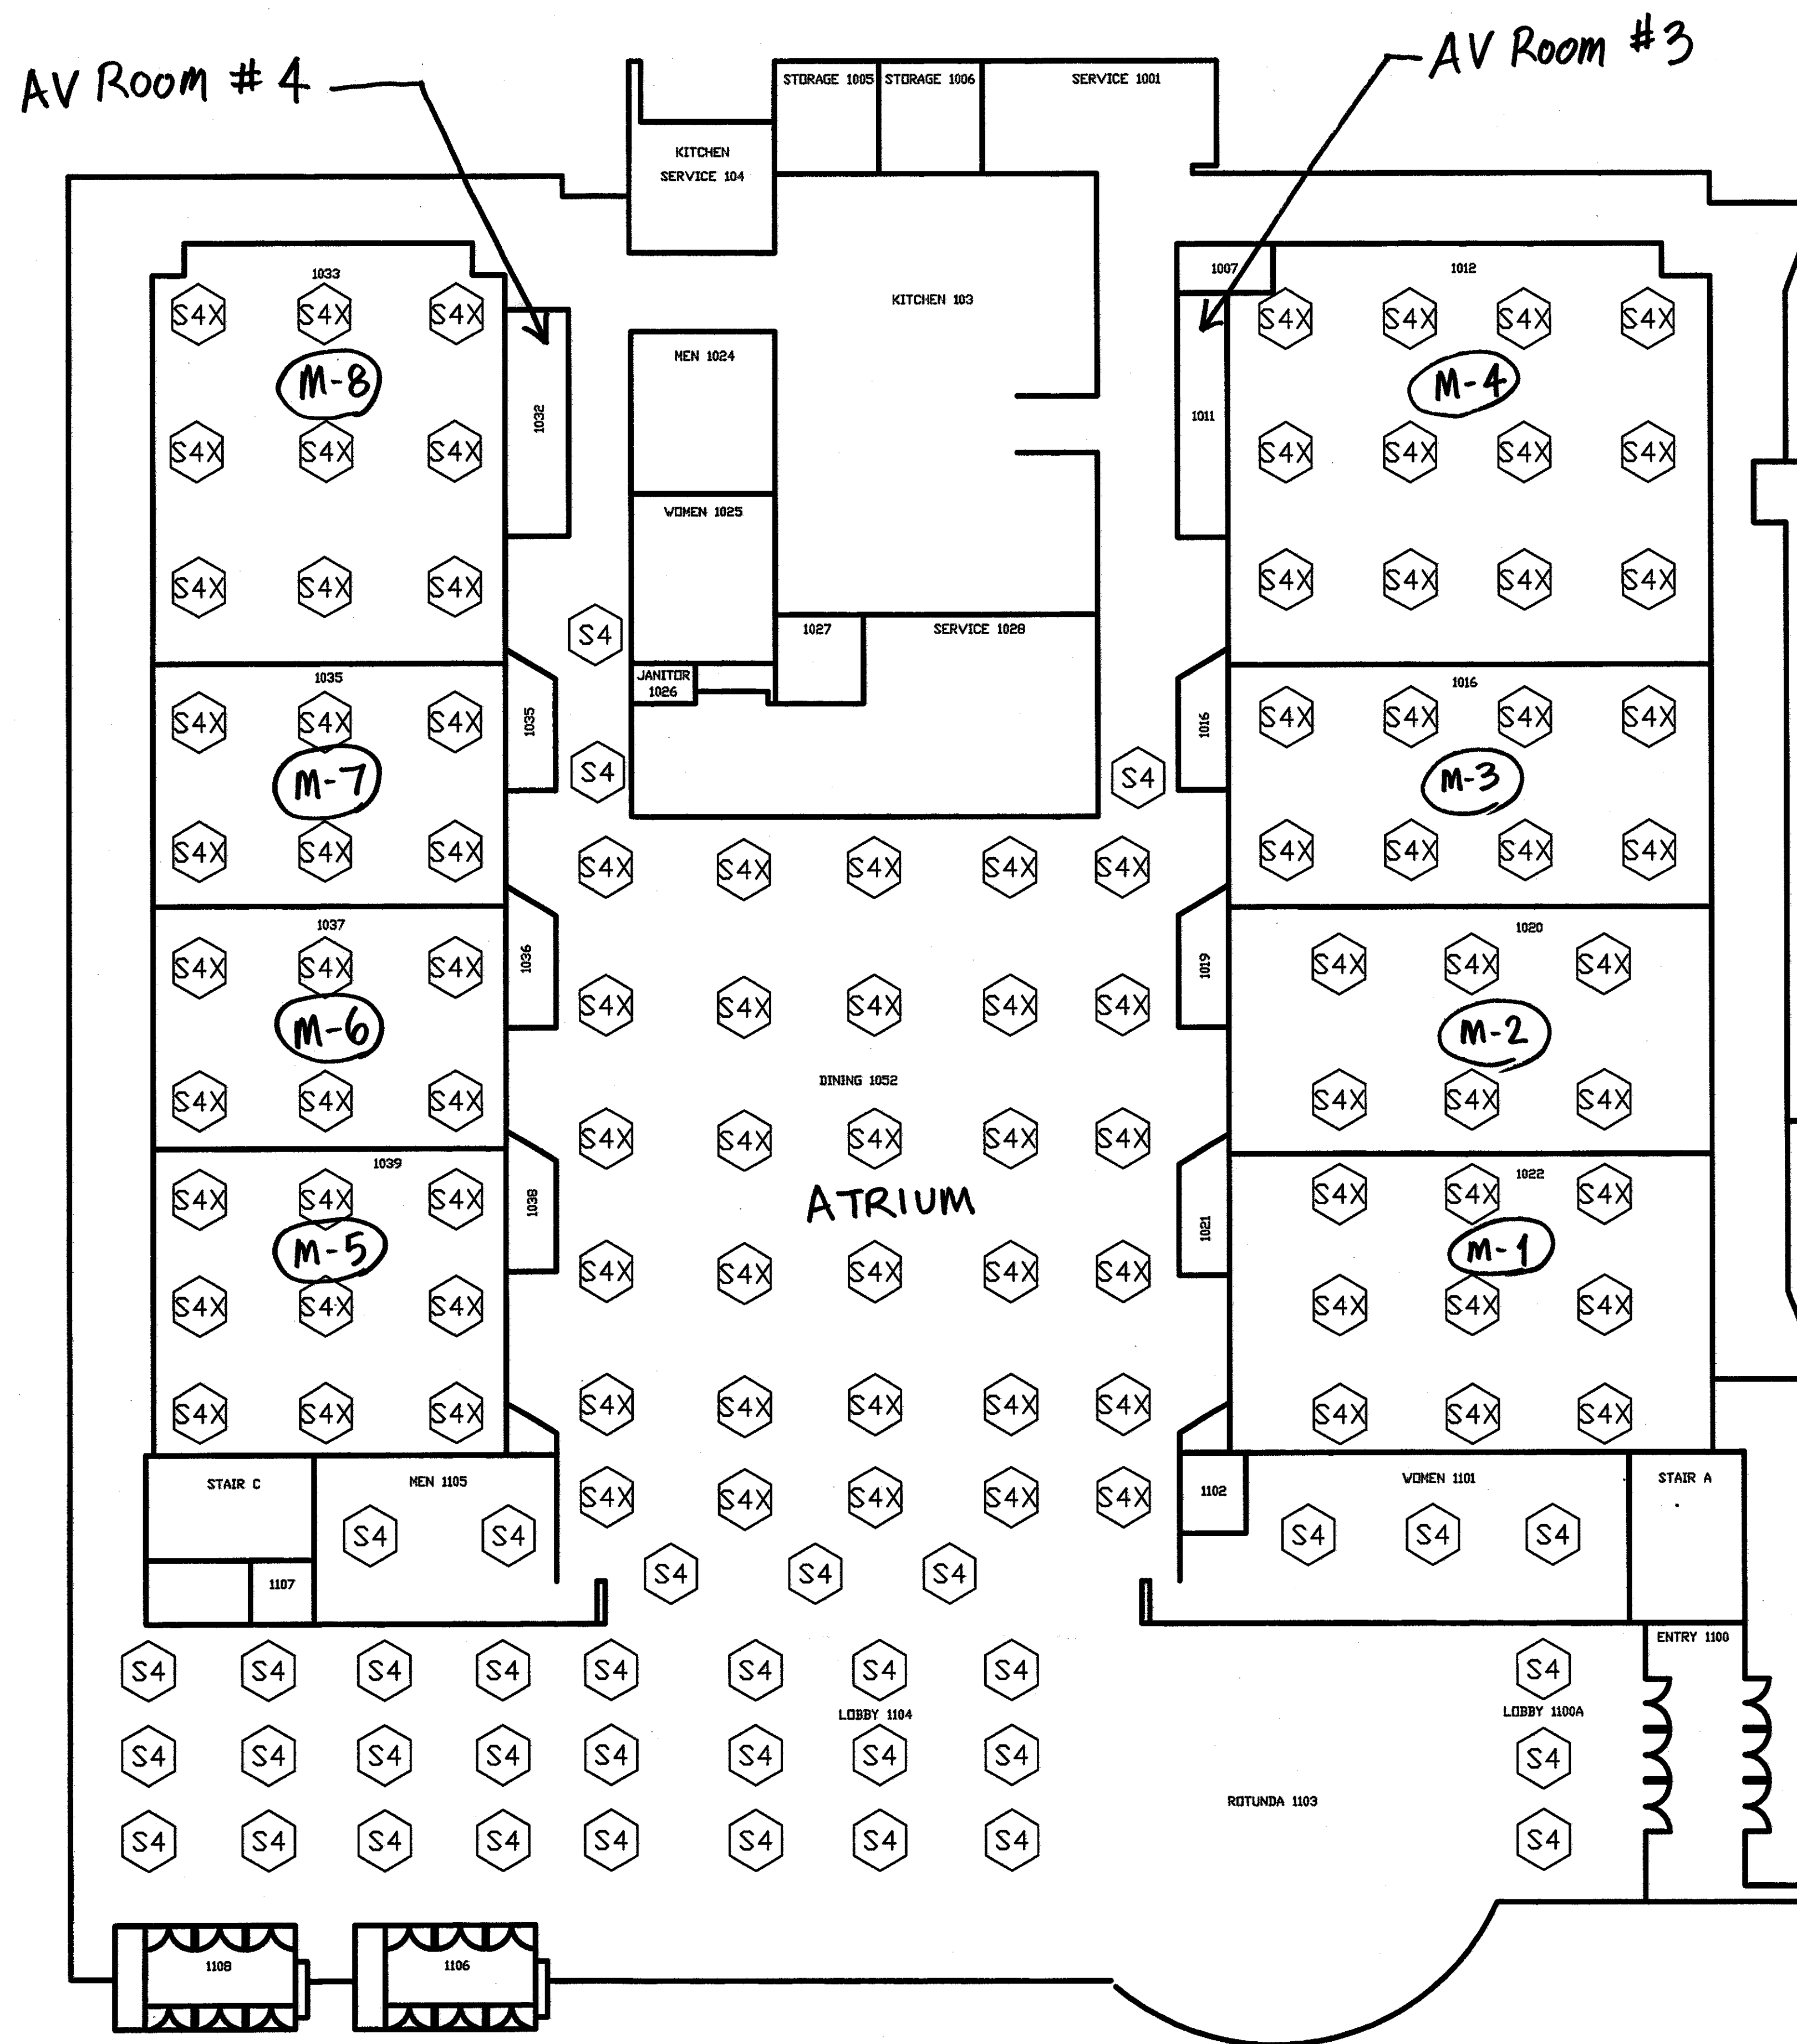

1. CONTRACTOR SHALL VERIFY THE EXISTING CONDITIONS AT THE PROJECT SITE BEFORE SUBMITTING COST PROPOSAL. CONTRACTOR IS ADVISED THAT ALL LOCATIONS ARE APPROXIMATE.
2. THESE AS-BUILTS MAKE AN ATTEMPT TO SHOW THE APPROXIMATE LOCATION OF ALL STRUCTURE, EQUIPMENT, FIXTURES, AND OUTLETS. THIS CONTRACTOR SHALL VISIT THE SITE TO VERIFY COMPONENTS, LOCATIONS AND SIZES SHOWN OR NOT SHOWN.
3. IT IS MANDATORY THAT THE EXISTING BUILDING REMAIN IN CONTINUOUS & NON-INTERRUPTED OPERATION DURING REMODELING/ALTERING OF THE EXISTING BUILDING. SERVICES TO AND WITHIN EXISTING BUILDING SHALL BE KEPT ON CONTINUOUS OPERATION. ANY ABSOLUTELY NECESSARY INTERRUPTION OF ANY SERVICES TO ACCOMPLISH PROJECT CONSTRUCTION SHALL BE ARRANGED WITH THE OWNER A MINIMUM OF TWO (2) WEEKS IN ADVANCE. TEMPORARY SERVICES SHALL BE FURNISHED AND INSTALLED WHERE NECESSARY TO ACCOMPLISH THIS PURPOSE. TEMPORARIES SHALL BE REMOVED ONLY AFTER NEW PERMANENT SERVICES ARE INSTALLED AND FULLY OPERATIONAL.
4. CONTRACTOR SHALL BE RESPONSIBLE FOR HIS OWN DEMOLITION, REMOVAL, CAPPING, STORING, ABANDONING, DISCONNECTING, RELOCATING AND RECONNECTION OF EXISTING EQUIPMENT AND MATERIAL. ALL CUTTING, PATCHING, REPAIRING, REPLACEMENT AND REFINISHING SHALL MATCH THE EXISTING CONSTRUCTION AS NEARLY AS POSSIBLE. CONSULT WITH OWNER REGARDING DIPOSITION OF ELECTRONIC EQUIPMENT TO BE REMOVED OR DEMOLISHED. IF OWNER DOES NOT WANT ITEMS, CONTRACTOR IS RESPONSIBLE FOR DISPOSAL.
5. THESE DRAWINGS ARE NECESSARILY DIAGRAMMATIC IN NATURE. NOT ALL CONNECTIONS, CABLES, OR EQUIPMENT ARE SHOWN. THE CONTRACTOR SHALL VISIT THE SITE PRIOR TO BIDDING AND INCLUDE ALL CONNECTIONS, CABLES, OR EQUIPMENT AS REQUIRED TO PROVIDE A COMPLETE AND FUNCTIONING SYSTEM.
6. SOME CABLES AND CONNECTIONS IN AV RACKS THAT ARE IN GOOD WORKING ORDER MAY BE RE-USED TO CONNECT TO NEW EQUIPMENT. CONFIRM WITH OWNER ANY EXISTING CABLES OR CONNECTIONS THAT MAY BE RE-USED. CONTRACTOR SHALL PROVIDE NEW CABLES AND CONNECTIONS WHERE REQUIRED FOR COMPLETE SYSTEM FUNCTION OR IF THERE IS DOUBT AS TO FUNCTIONALITY OF EXITING CABLES AND CONNECTIONS.
7. NO WARRANTY IS MADE REGARDING THE COMPLETENESS OR ACCURACY OF THESE AS-BUILT DRAWINGS.

DEVICE LOCATION DIAGRAM - FORUM - LOUDSPEAKERS
SOUND SYSTEM SHOP DRAWINGS
DANE COUNTY EXPOSITION CENTER - MADISON, WI
SCALE: NONE DATE: 18 OCTUBER 1994 DWG NO.: DECECDVL3.DWG